

**Mono County
Community Development Department**

PO Box 347
Mammoth Lakes CA, 93546
760.924.1800, fax 924.1801
commdev@mono.ca.gov

Planning Division

PO Box 8
Bridgeport, CA 93517
(760) 932-5420, fax 932-5431
www.monocounty.ca.gov

**USE PERMIT
APPLICATION**

APPLICATION # _____	FEE \$ _____
DATE RECEIVED _____	RECEIVED BY _____
RECEIPT # _____	CHECK # _____ (NO CASH)

APPLICANT/AGENT Dean Hemminger

ADDRESS 194 Wunderlich Way CITY/STATE/ZIP Coleville, CA 96107

TELEPHONE (408) 694-8778 E-MAIL deanhemminger@sbcglobal.net

OWNER, if other than applicant _____

ADDRESS _____ CITY/STATE/ZIP _____

TELEPHONE (_____) _____ E-MAIL _____

PROPERTY DESCRIPTION:

Assessor's Parcel # 002-440-029-000 General Plan Land Use Designation RR5

PROPOSED USE: Describe the proposed project in detail, using additional sheets if necessary.

NOTE: An incomplete or inadequate project description may delay project processing.

Allow previously installed overhead power lines and poles to remain in place

See attached files:

- Use Permit Project Description
- Site Map 1
- Site Map 2
- Cruz Construction estimate
- Liberty Utilities estimate emails
- Liberty Utilities cost letters and map

I CERTIFY UNDER PENALTY OF PERJURY THAT I am: legal owner(s) of the subject property (all individual owners must sign as their names appear on the deed to the land), corporate officer(s) empowered to sign for the corporation, or owner's legal agent having Power of Attorney for this action (a notarized "Power of Attorney" document must accompany the application form), AND THAT THE FOREGOING IS TRUE AND CORRECT.

Dean Hemminger
Signature

Signature


12/17/2020
Date

Site Map 1

APN 002-440-029-000



Liberty Utilities
 1-800-855-8888
 www.libertyutilities.com

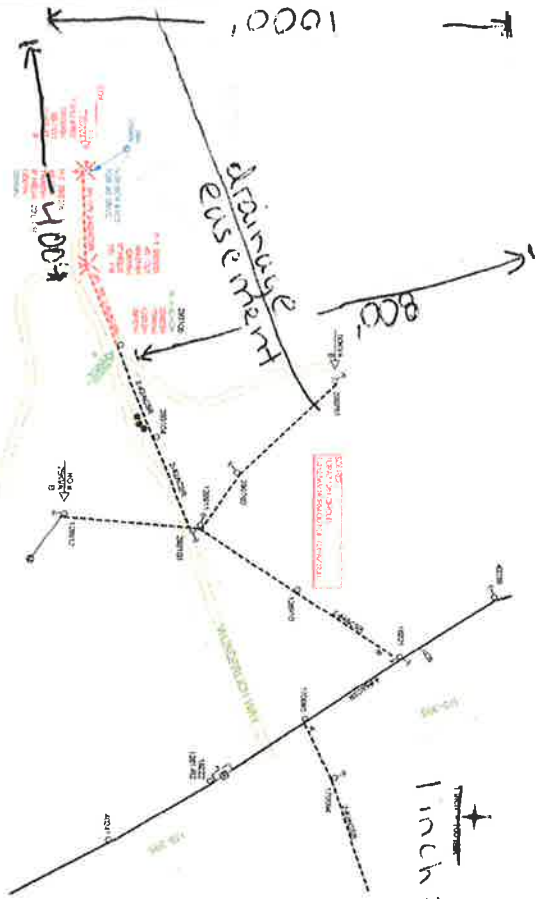













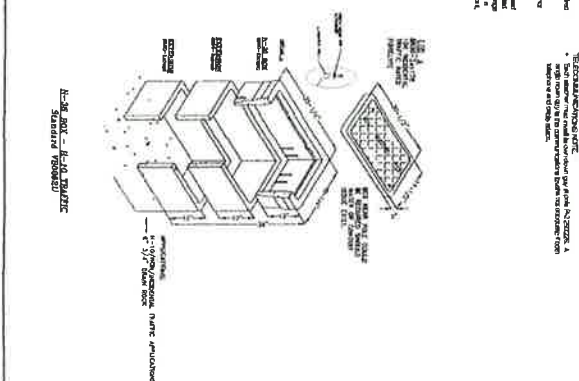

Call before you dig

800-487-3372

LIBERTY UTILITIES

CONTRACTOR



Site Map 2

